

ELEVATION CERTIFICATE

FEDERAL EMERGENCY MANAGEMENT AGENCY NATIONAL FLOOD INSURANCE PROGRAM

ATTENTION: Use of this certificate does not provide a waiver of the flood insurance purchase requirement. This form is used only to provide elevation information necessary to ensure compliance with applicable community floodplain management ordinances, to determine the proper insurance premium rate, and/or to support a request for a Letter of Map Amendment or Revision (LOMA or LOMR). Instructions for completing this form can be found on the following pages.

SECTION A PROPERTY INFORMATION		FOR INSURANCE COMPANY USE
BUILDING OWNER'S NAME Ethan Allen Corp.	POLICY NUMBER	
STREET ADDRESS (Including Apt., Unit, Suite and/or Bldg. Number) OR P.O. ROUTE AND BOX NUMBER 2725 NE 163 Street	COMPANY NAIC NUMBER	
OTHER DESCRIPTION (Lot and Block Numbers, etc.)		
CITY North Miami Beach	STATE Florida	ZIP CODE 33162

SECTION B FLOOD INSURANCE RATE MAP (FIRM) INFORMATION

Provide the following from the proper FIRM (See Instructions):

1. COMMUNITY NUMBER	2. PANEL NUMBER	3. SUFFIX	4. DATE OF FIRM INDEX	5. FIRM ZONE	6. BASE FLOOD ELEVATION (in AO Zones, use depth)
120656	0084	J	3/2/94	AE	+8'

7. Indicate the elevation datum system used on the FIRM for Base Flood Elevations (BFE): NGVD '29 Other (describe on back)
8. For Zones A or V, where no BFE is provided on the FIRM, and the community has established a BFE for this building site, indicate the community's BFE: feet NGVD (or other FIRM datum—see Section B, Item 7).

SECTION C BUILDING ELEVATION INFORMATION

- Using the Elevation Certificate Instructions, indicate the diagram number from the diagrams found on Pages 5 and 6 that best describes the subject building's reference level 1.
- 2(a). FIRM Zones A1-A30, AE, AH, and A (with BFE). The top of the reference level floor from the selected diagram is at an elevation of feet NGVD (or other FIRM datum—see Section B, Item 7).
- (b). FIRM Zones V1-V30, VE, and V (with BFE). The bottom of the lowest horizontal structural member of the reference level from the selected diagram, is at an elevation of feet NGVD (or other FIRM datum—see Section B, Item 7).
- (c). FIRM Zone A (without BFE). The floor used as the reference level from the selected diagram is feet above or below (check one) the highest grade adjacent to the building.
- (d). FIRM Zone AO. The floor used as the reference level from the selected diagram is feet above or below (check one) the highest grade adjacent to the building. If no flood depth number is available, is the building's lowest floor (reference level) elevated in accordance with the community's floodplain management ordinance? Yes No Unknown
3. Indicate the elevation datum system used in determining the above reference level elevations: NGVD '29 Other (describe under Comments on Page 2). (NOTE: If the elevation datum used in measuring the elevations is different than that used on the FIRM [see Section B, Item 7], then convert the elevations to the datum system used on the FIRM and show the conversion equation under Comments on Page 2.)
4. Elevation reference mark used appears on FIRM: Yes No (See Instructions on Page 4)
5. The reference level elevation is based on: actual construction construction drawings
(NOTE: Use of construction drawings is only valid if the building does not yet have the reference level floor in place, in which case this certificate will only be valid for the building during the course of construction. A post-construction Elevation Certificate will be required once construction is complete.)
6. The elevation of the lowest grade immediately adjacent to the building is: feet NGVD (or other FIRM datum—see Section B, Item 7).

SECTION D COMMUNITY INFORMATION

1. If the community official responsible for verifying building elevations specifies that the reference level indicated in Section C, Item 1 is not the "lowest floor" as defined in the community's floodplain management ordinance, the elevation of the building's "lowest floor" as defined by the ordinance is: feet NGVD (or other FIRM datum—see Section B, Item 7).
2. Date of the start of construction or substantial improvement _____

SECTION E CERTIFICATION

This certification is to be signed by a land surveyor, engineer, or architect who is authorized by state or local law to certify elevation information when the elevation information for Zones A1-A30, AE, AH, A (with BFE), V1-V30, VE, and V (with BFE) is required. Community officials who are authorized by local law or ordinance to provide floodplain management information, may also sign the certification. In the case of Zones AO and A (without a FEMA or community issued BFE), a building official, a property owner, or an owner's representative may also sign the certification.


Reference level diagrams 6, 7 and 8 - Distinguishing Features-If the certifier is unable to certify to breakaway/non-breakaway wall, enclosure size, location of servicing equipment, area use, wall openings, or unfinished area Feature(s), then list the Feature(s) not included in the certification under Comments below. The diagram number, Section C, Item 1, must still be entered.

I certify that the information in Sections B and C on this certificate represents my best efforts to interpret the data available. I understand that any false statement may be punishable by fine or imprisonment under 18 U.S. Code, Section 1001.

CERTIFIER'S NAME Daniel C. Fortin		LICENSE NUMBER (or Affix Seal) 2853	
TITLE Prof. Land Surveyor		COMPANY NAME Fortin, Leavy, Skiles, Inc.	
ADDRESS 180 NE 168 Street		CITY North Miami Beach	STATE ZIP Florida 33162
SIGNATURE <i>[Handwritten Signature]</i>		DATE 7/13/94	PHONE 305/653-4493

Copies should be made of this Certificate for: 1) community official, 2) insurance agent/company, and 3) building owner.

COMMENTS: _____

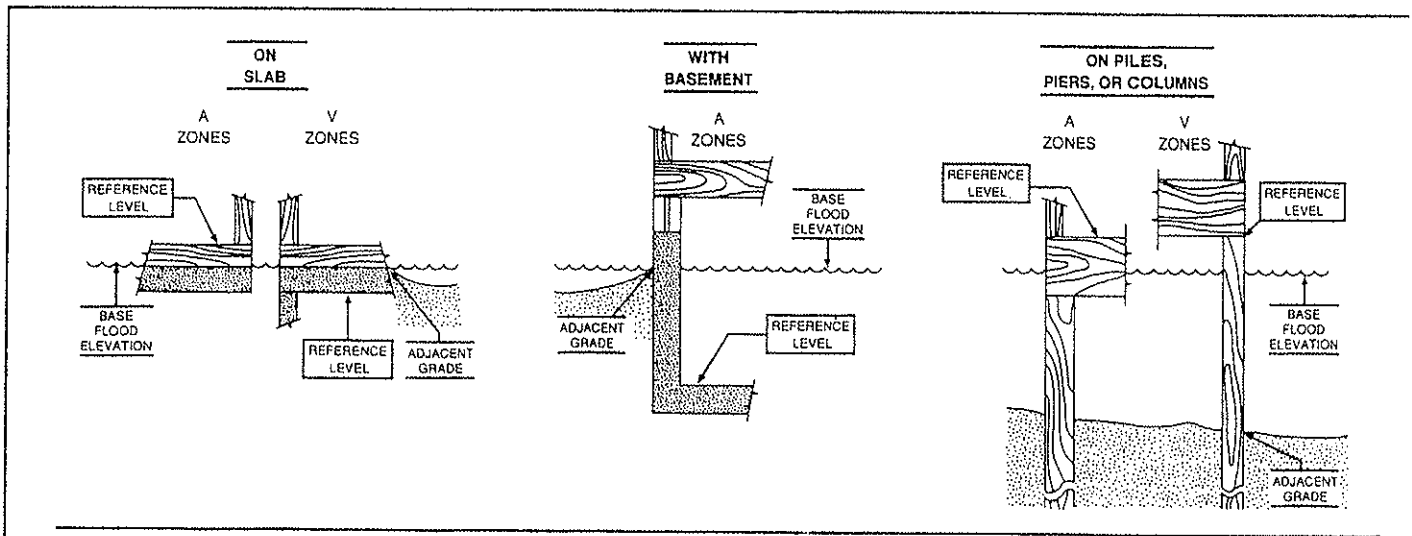

The diagrams above illustrate the points at which the elevations should be measured in A Zones and V Zones. Elevations for all A Zones should be measured at the top of the reference level floor. Elevations for all V Zones should be measured at the bottom of the lowest horizontal structural member.

As-Built ELEVATION CERTIFICATE

To complete refer to Elevation Certificate Guidelines. This certificate shall be presented in duplicate to DERM Water Control before obtaining a CERTIFICATE OF COMPLETION OR OCCUPANCY.

Inspectors: DO NOT ACCEPT if all item are not completed

PROPERTY INFORMATION

(The following information to be provided by contractor or property owner, please Print)

Folio # : _____ (DO NOT ACCEPT WITHOUT FOLIO#)

Address : 2725 NE 163 Street

Process # : _____ Permit # : _____

FLOOD INSURANCE RATE MAP INFORMATION

Community #	Suffix	Panel #	Date of FIRM	FIRM Zone	Base Flood
1206	J	0084	March 2, 1994	AE	+8 Ft. NGVD

If any Variance or Waiver has been obtained from Metropolitan Dade County D.E.R.M.

Please provide case NUMBER # _____

All areas below the base flood elevation are in compliance with _____

I certify that the above information represents my best effort to interpret the data requested :

Name : _____ Date : _____

Phone # _____

Signature _____

ELEVATION CERTIFICATE

Using Elevation Certificate instructions, indicate diagram found on Pages 5 and 6 that best describes the subject building's reference level _____

LOWEST ADJACENT GRADE ELEVATION..... 7.5 FT. N.G.V.D.
 LOWEST FLOOR ELEVATION (Top Reference level) 7.87 FT. N.G.V.D.
 GARAGE OR STORAGE FLOOR ELEVATION n/a FT. N.G.V.D.
 ELEVATION OF HIGHEST CROWN OF ROAD .. (Fronting Property) .. 4.90 FT. N.G.V.D.

(IF IN A "VE" FLOOD ZONE AREA)

BOTTOM ELEVATION OF THE LOWEST HORIZONTAL STRUCTURAL MEMBER..... FT. N. G. V. D.

I hereby certify that the information on this certificate for the above mentioned property is true and correct to the best of my knowledge and belief.

Date : 7/13/94

Phone #: (305)653-4493
Certifier's

Certifier Name : Daniel C. Fortin
Signature _____ (Print)

Certificate # : 2853 PLS. TYPE
(Circle One)